




**Design Center Request  
Change Order #2**


Change Order Date: 10/10/2016

| Buyer                                  | Property                                                                                                                      | Transaction                                                                   |
|----------------------------------------|-------------------------------------------------------------------------------------------------------------------------------|-------------------------------------------------------------------------------|
| Miles A Klickman<br>Rebekah R Klickman | Community: Tyger Pointe<br>Lot: 40<br>Floor Plan: Julian / Elevation A<br>Property: 512 Furman Creek Court<br>Moore, SC 29369 | Previous Total: \$ 198,003.00<br>Changes: \$ 0.00<br>New Total: \$ 198,003.00 |

**Redlines**

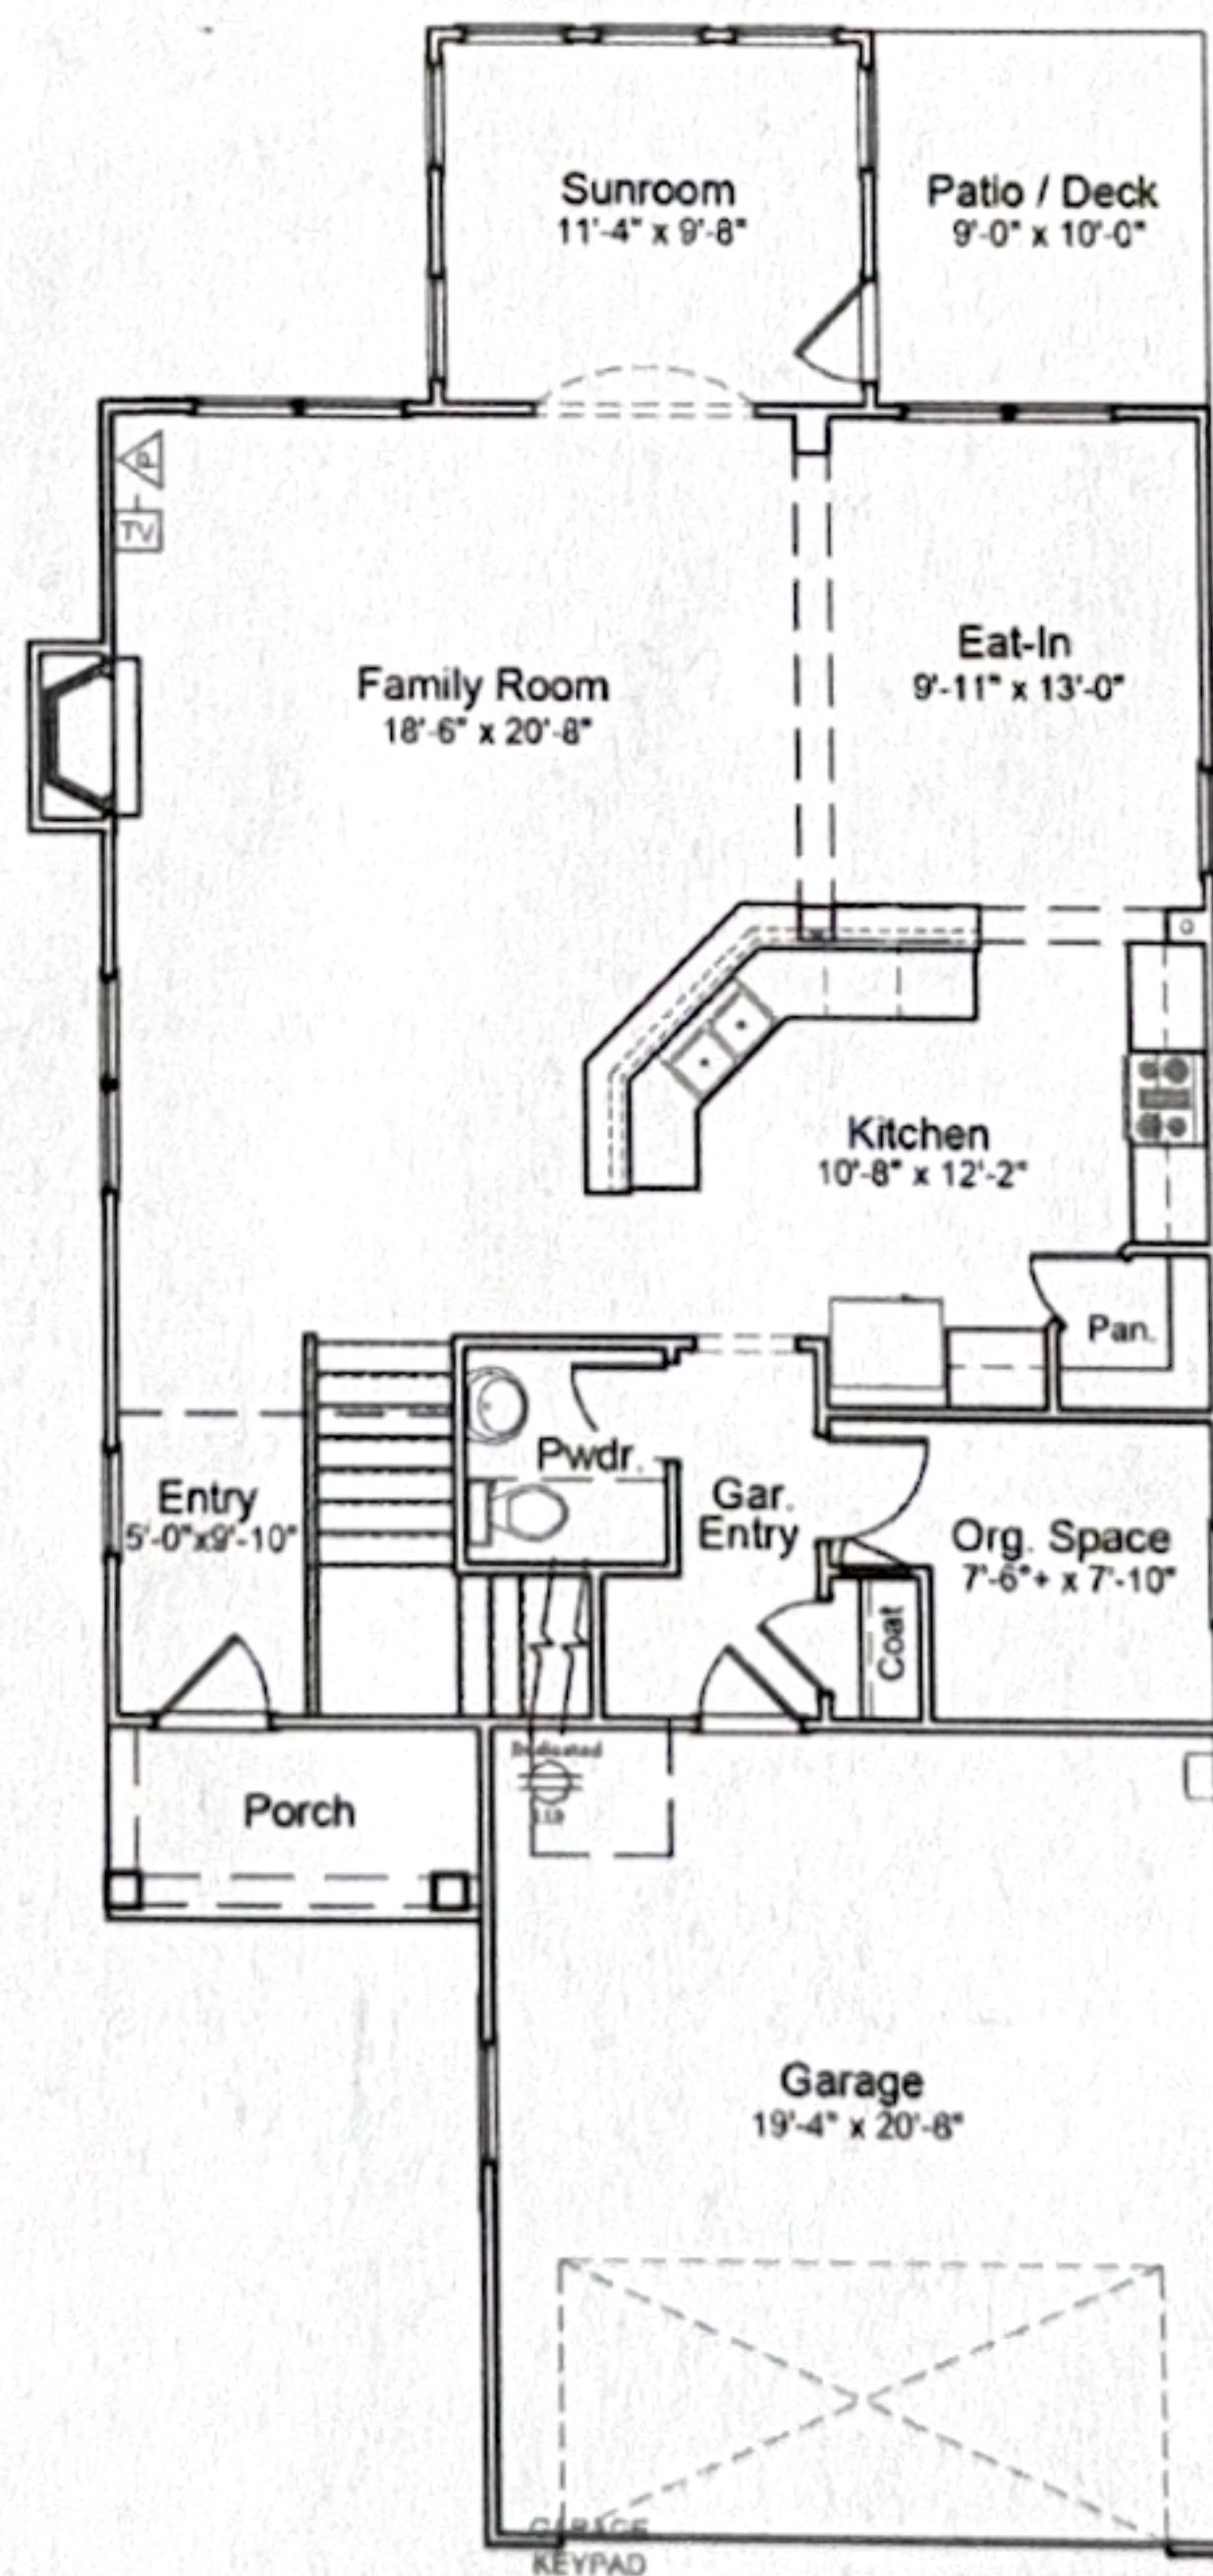

MK 10/10/16

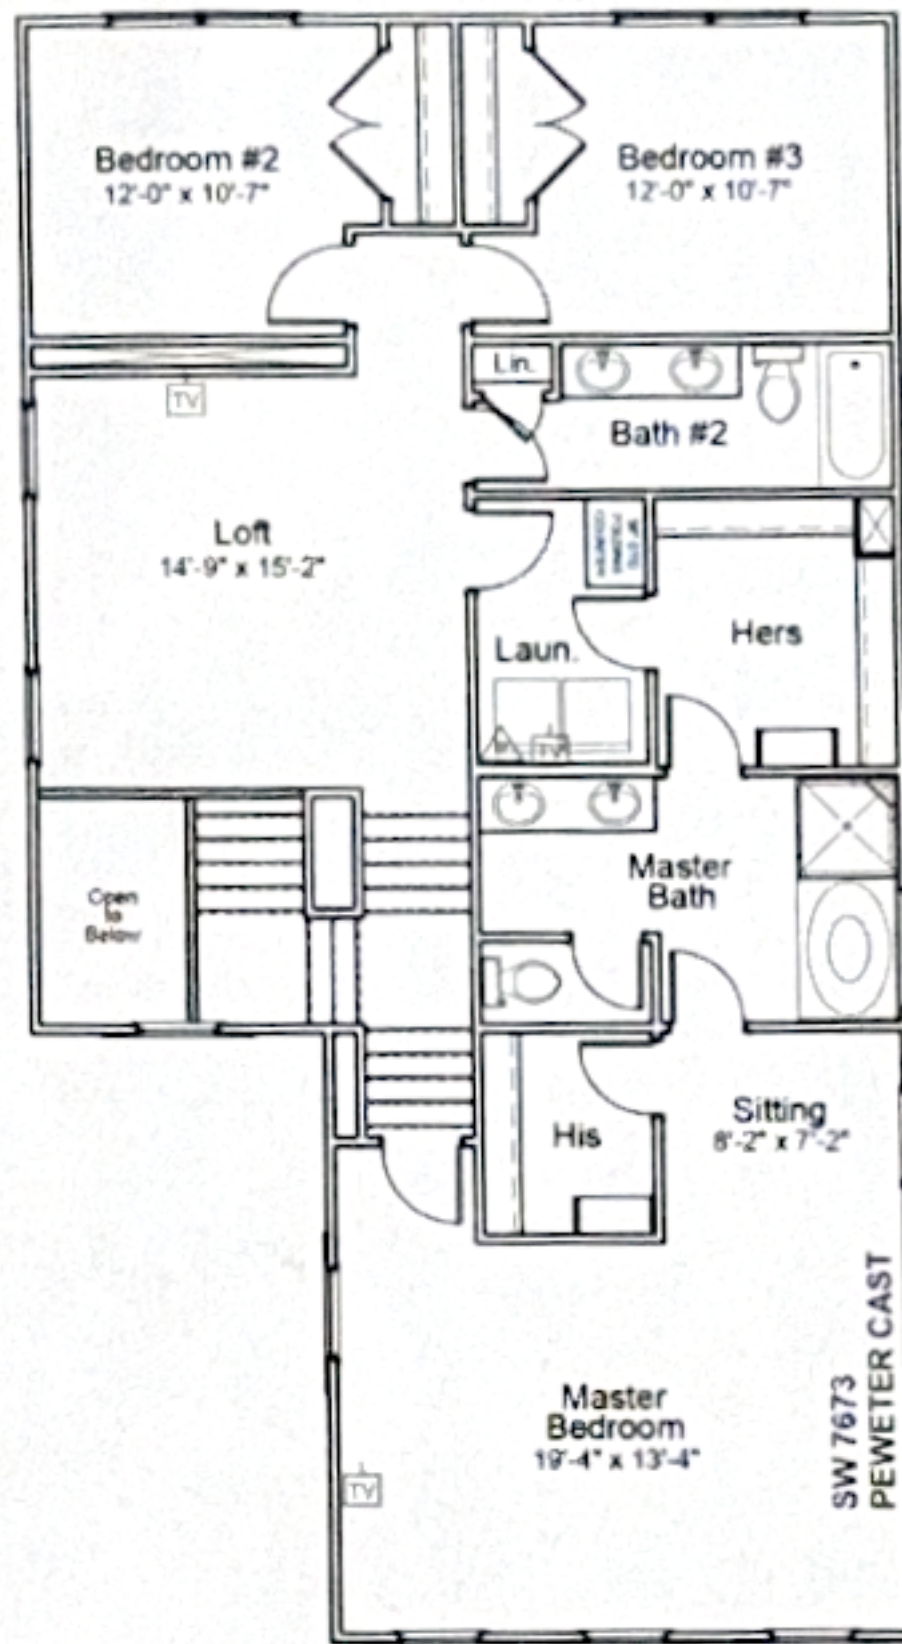

MK

10/10/16